


AS-BUILT PLANS 12/12/12

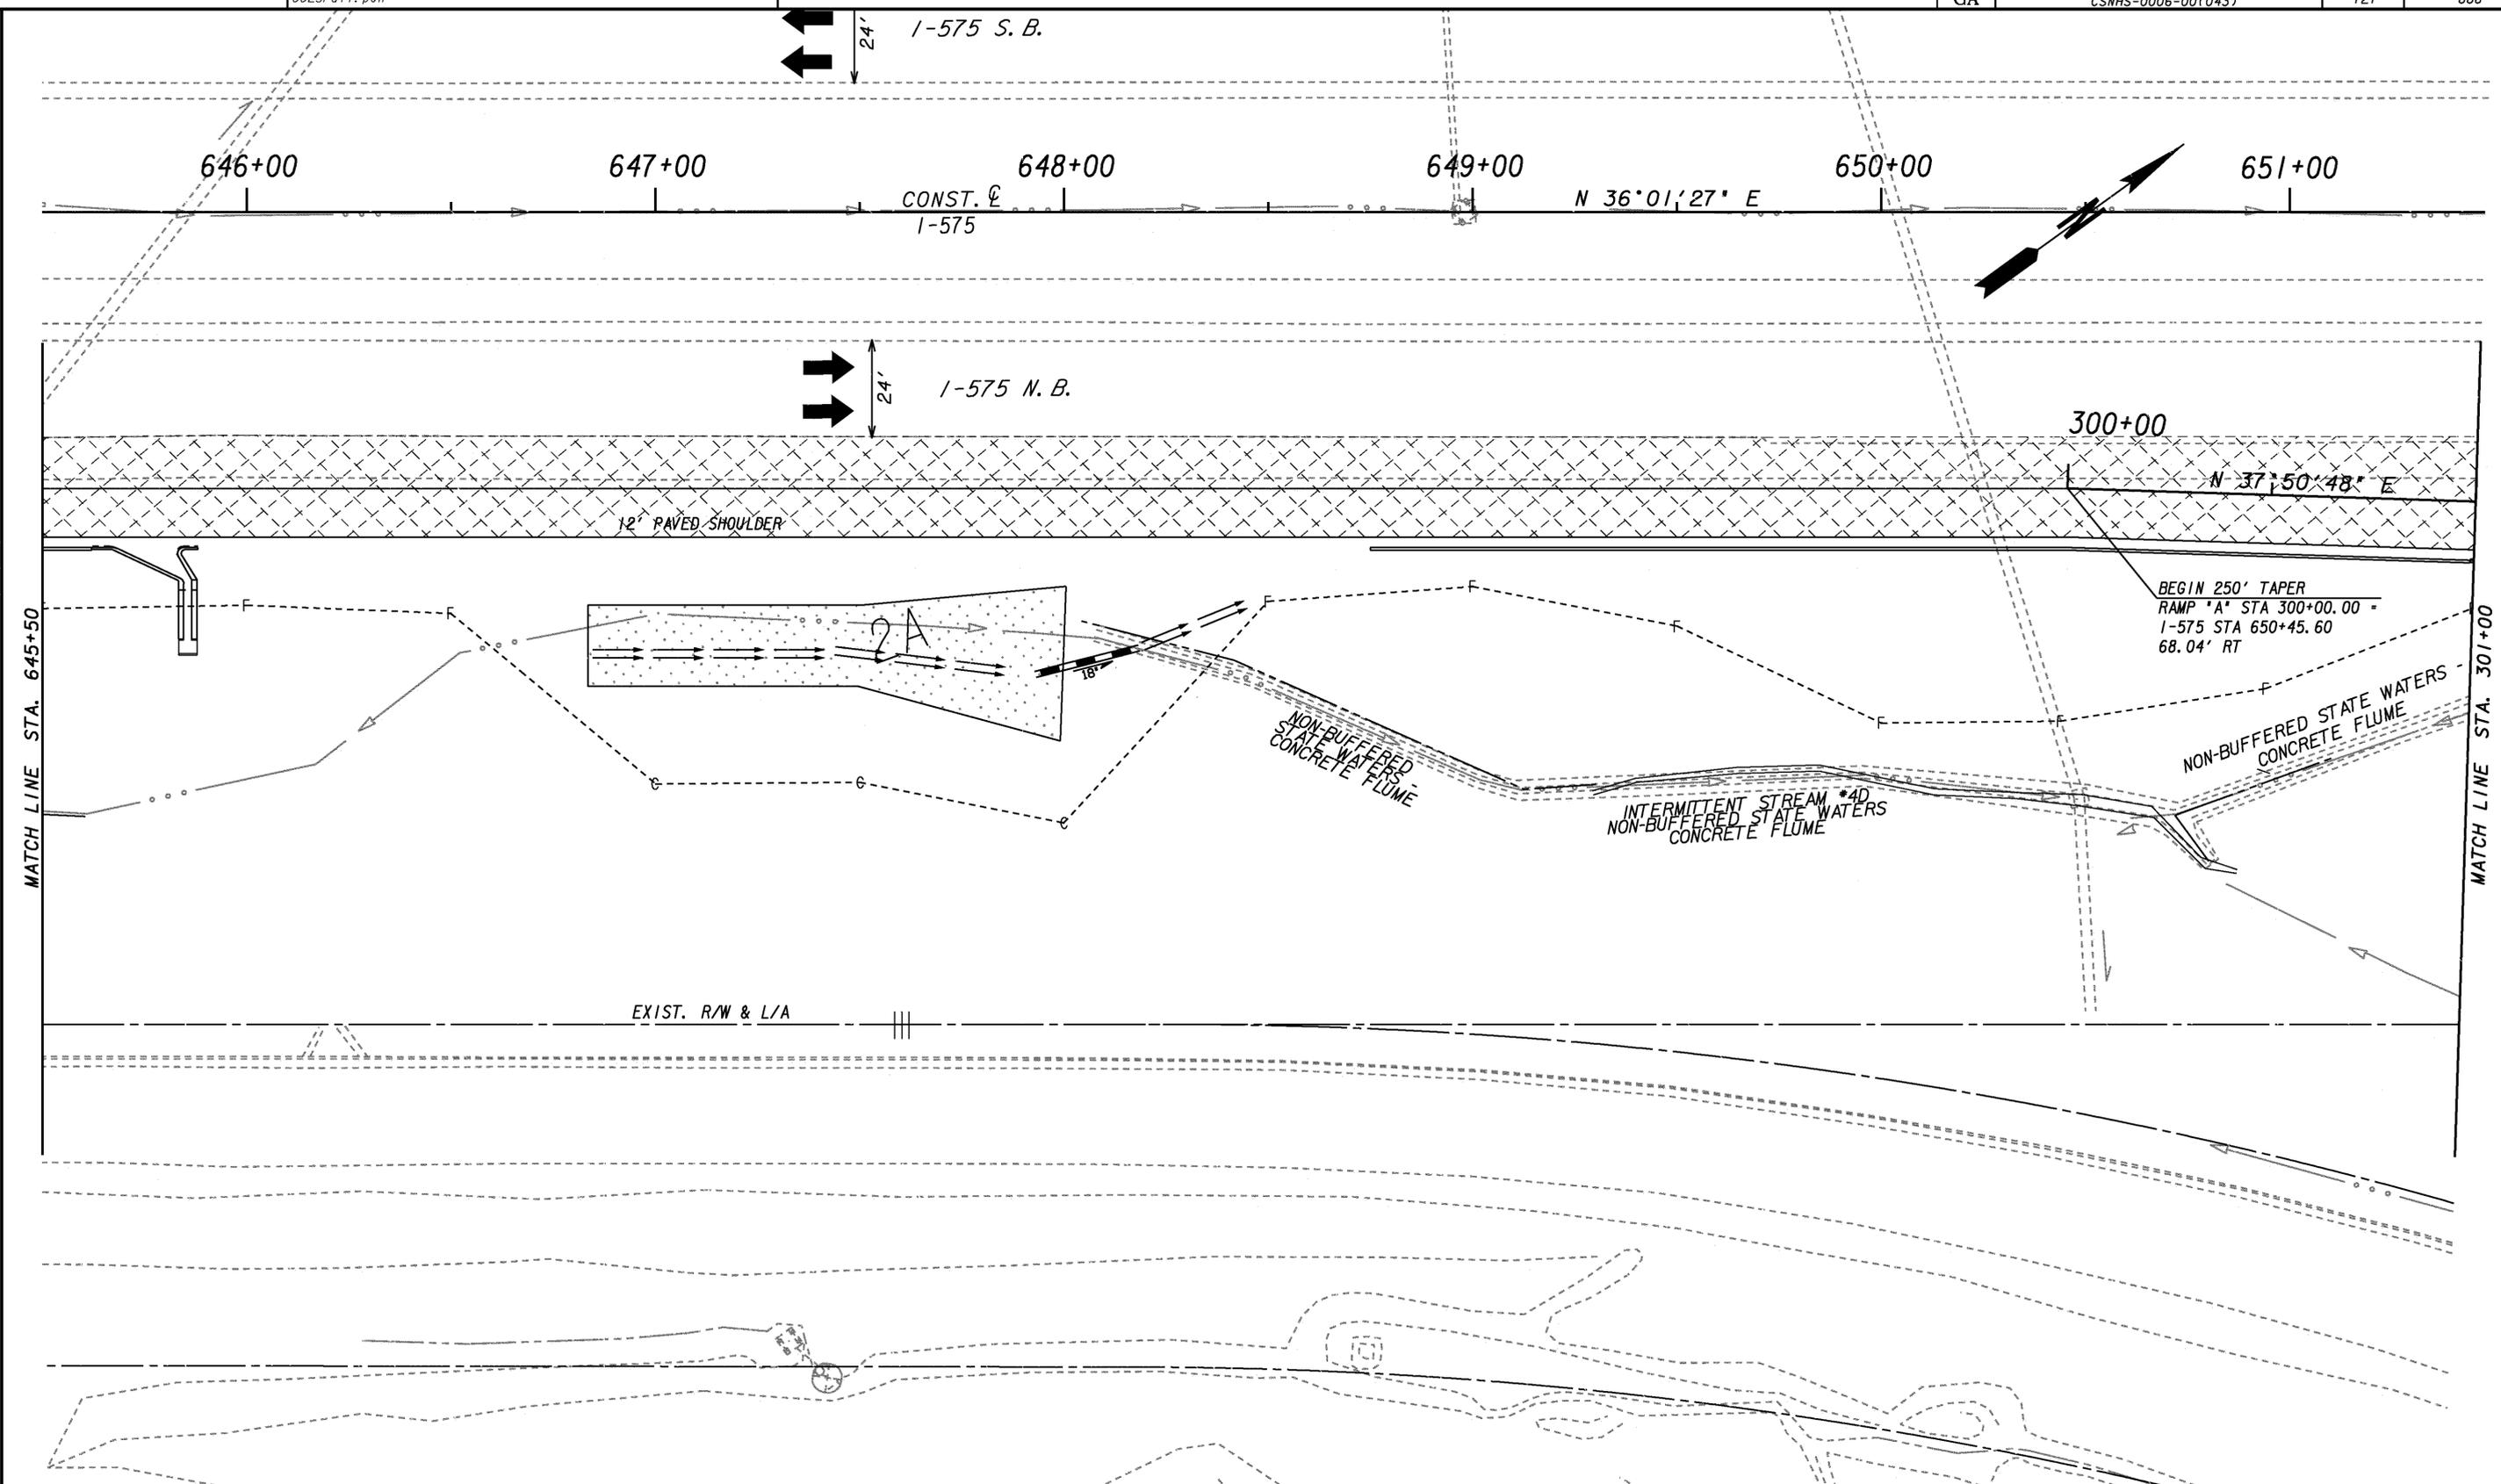


LEGEND

PAVEMENT REMOVAL	
TEMPORARY CONSTRUCTION PAVEMENT	
PERMANENT CONSTRUCTION	
CONCRETE MEDIAN CONSTRUCTION	
MILL & OVERLAY CONSTRUCTION	
OPEN LANES OF TRAFFIC	

STAGE I PHASE I

THE LPA GROUP
TRANSPORTATION CONSULTANTS

3595 ENGINEERING DRIVE
NORCROSS, GEORGIA 30092
(770) 263-9118

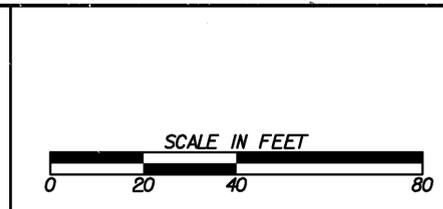

REVISION DATES

STATE OF GEORGIA
DEPARTMENT OF TRANSPORTATION
OFFICE: INNOVATIVE PROGRAM DELIVERY

CONSTRUCTION STAGING PLAN

I-575 NB AUXILIARY LANE
STA. 645+50 TO STA. 651+50

DRAWING No. 19-020